


OPERATIONS COMPONENTS - LEGEND

- 1 GRADED WORKING SURFACE
- 2 GRADED AND MAINTAINED WORK AREAS
BOTH SIDES OF FLUME. APPEARS FOR
PROTECTION, ACCESS AND
MAINTENANCE.
- 3 GRAVEL ACCESS ROAD AND WORK
AREA DONE AFTER 2019 WORK IN
WATER, SURFACE CRUSHED ROCK
- 4 SHORELINE RIP RAP
- 5 WOOD DIVERSION SPILLWAY
- 6 ROCK CHUTES
- 7 INTAKE TO FLUME
- 8 FLOOD GATES

- | | |
|----|---|
| 9 | BRIDGE CROSSING RIVER |
| 10 | FISH LADDER |
| 11 | RUNOFF BIO-TREATMENT AREA |
| 12 | GRADING FROM CONSTRUCTION
ACTIVITY |
| 13 | UPPER LANDING STORAGE, ASSEMBLY
AND CONCRETE PLANT |
| 14 | ROCK STORAGE |

- 15 MAINTAINED DRAINAGE $\pm 1,100'$
16 DE-WATERING SEDIMENT
POND/ACCLIMATION POND
17 TEMPORARY ROCK FILLED DAM

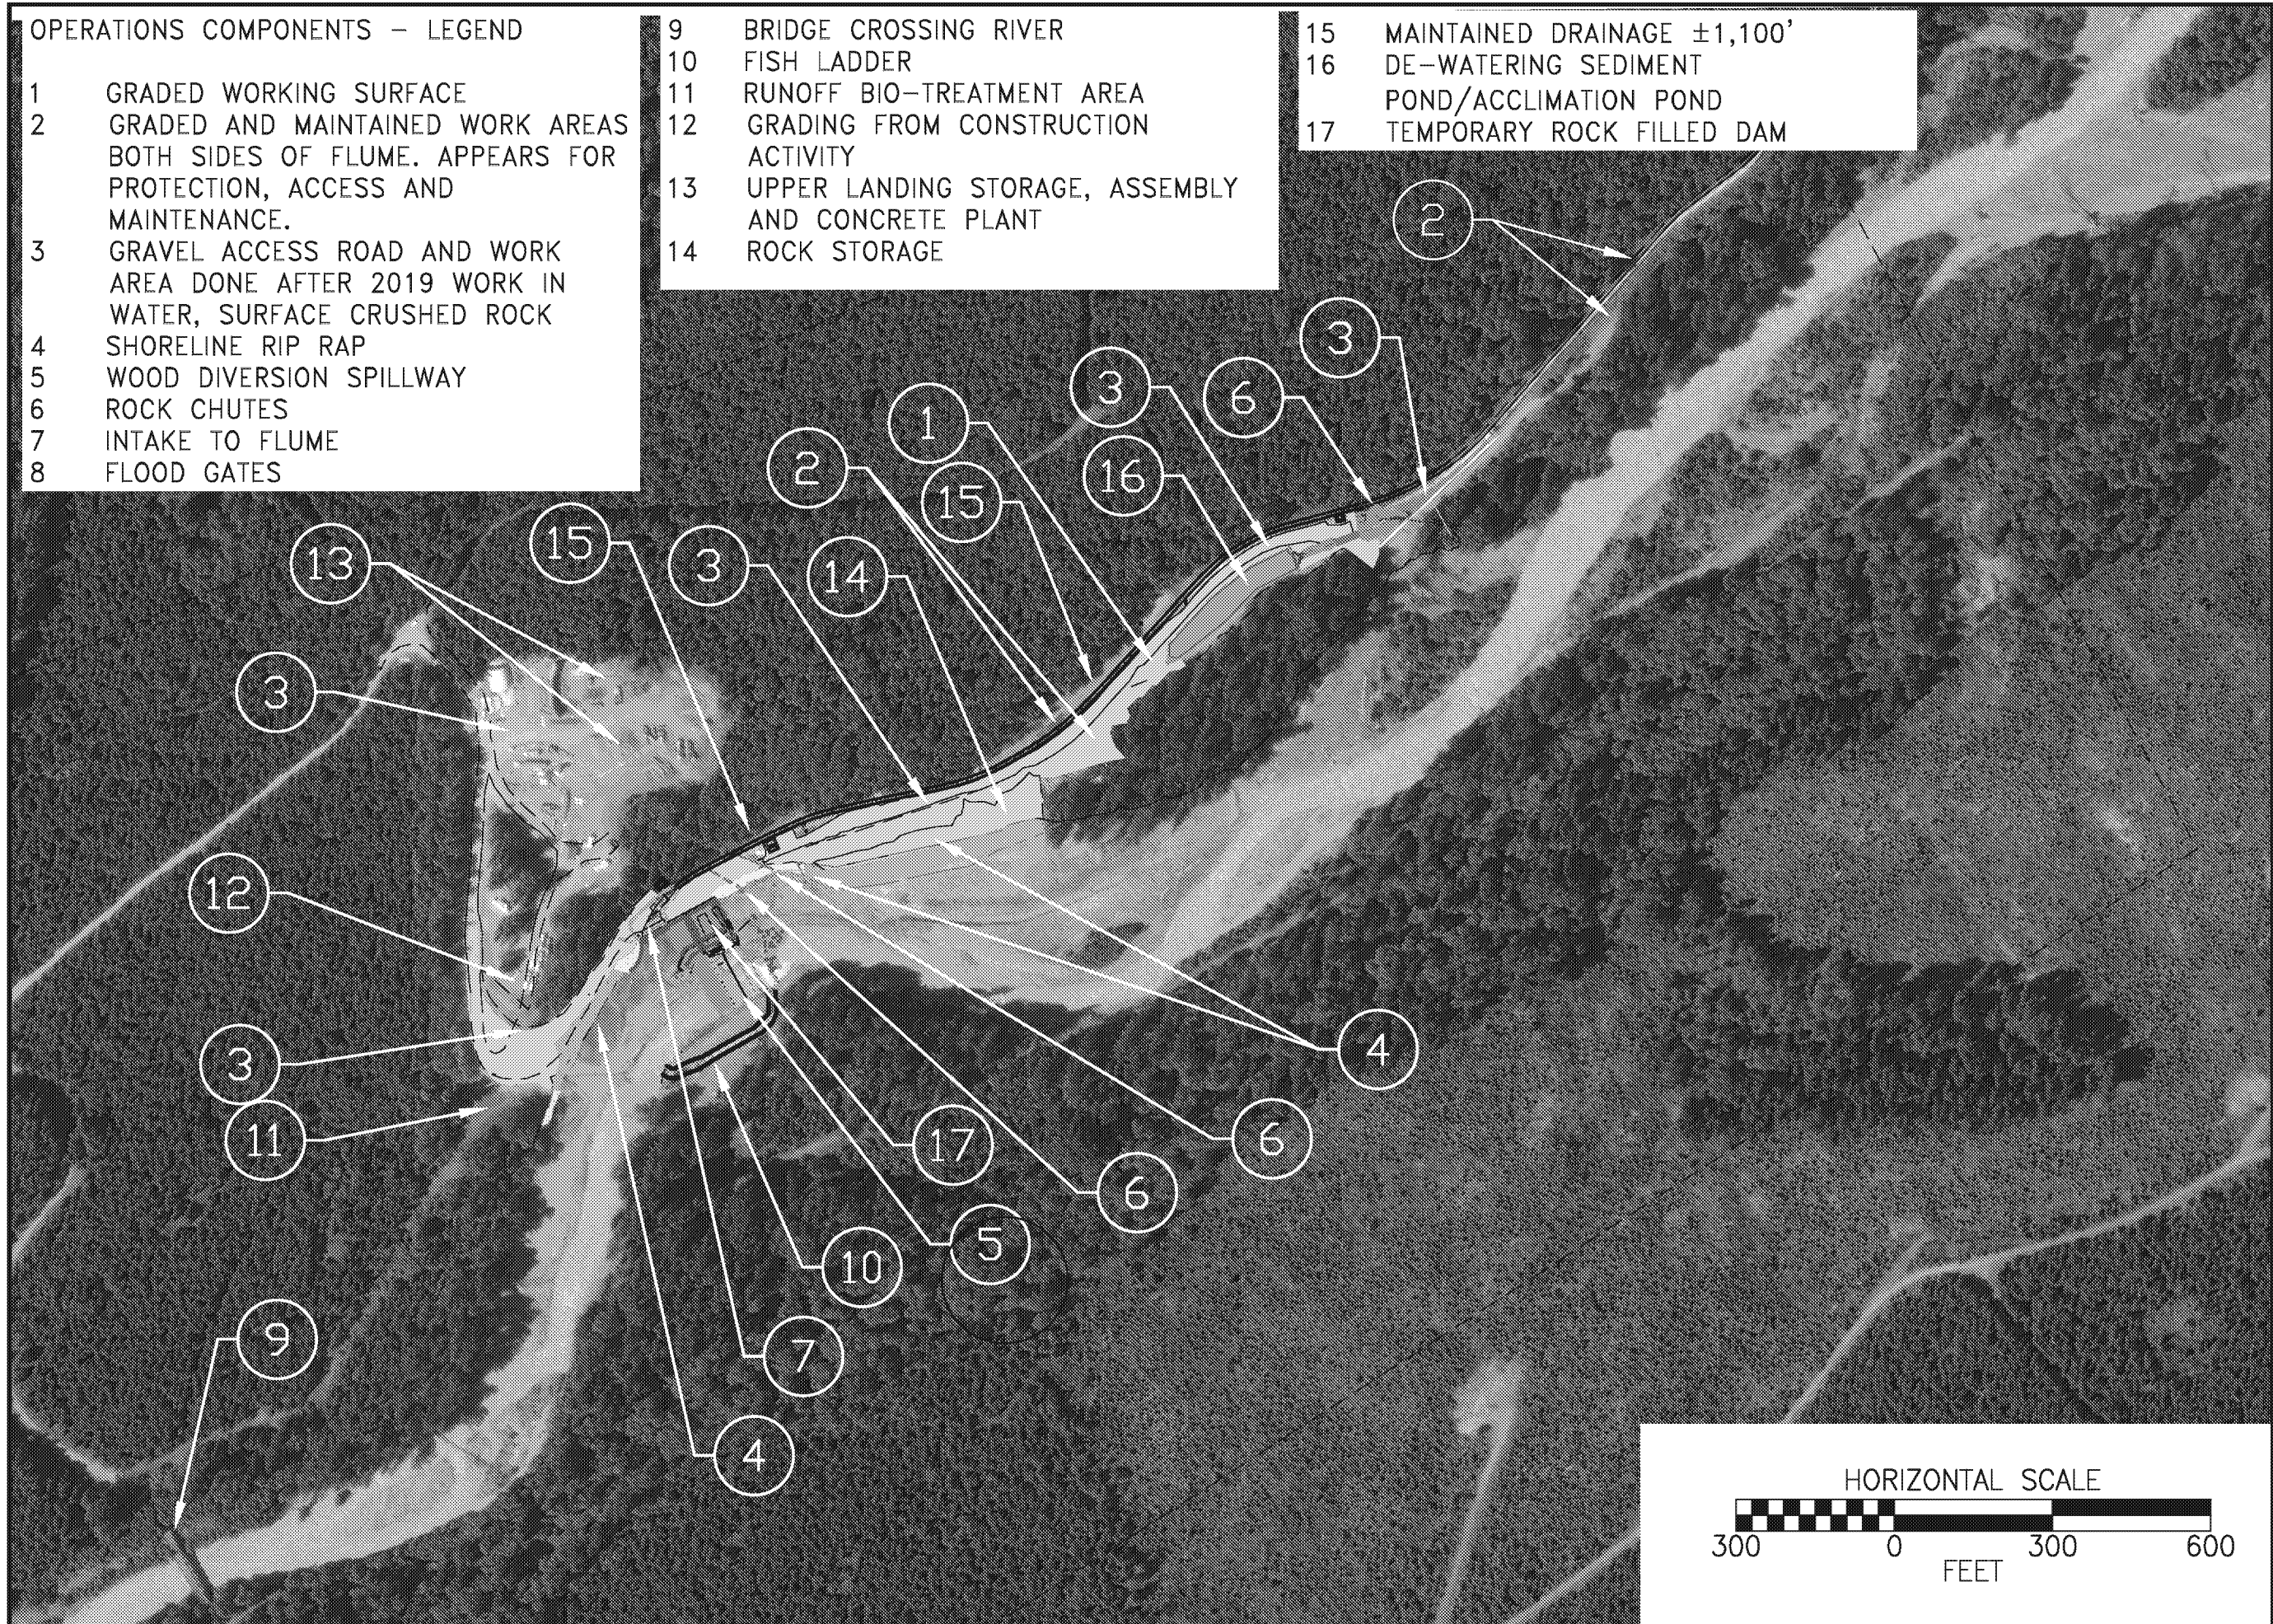

9			
8			
7			
6			
5			
4			
3			
2			
1			
NO.	DATE	REVISION	BY CK

ELECTRON HYDROELECTRIC PROJECT

2020-08-10 Site Plan
As-constructed

PIERCE COUNTY

WASHINGTON

Scale: 1" = 300'

DESIGN:
DRAWN: SPG
CHECKED:

DATE: 1/6/2021
JOB#: 11011900

SHEET 14	OF 15
----------	-------

DRAWING

14